



HYDRATION ROOM

PERMIT SET

555 SAN ANTONIO ROAD, SUITE # 39
MOUNTAIN VIEW, CA 94040


PROJECT DIRECTORY		PROJECT SCOPE / DATA		CODE SUMMARY		Permit Set Details																							
OWNER / TENANT COMPANY: HYDRATION ROOM CONTACT: SHAUN HAYWARD, VICE PRESIDENT, OPERATIONS AND NEW STORES ADDRESS:		EXISTING OCCUPANCY / CLASSIFICATION: (B) BUSINESS NO CHANGE OF USE EXISTING CONSTRUCTION TYPE: II B EXISTING GROSS LEASE AREA: 1,644 SF TOTAL OCCUPANTS: 11 REFER TO SHEET A001 EXISTING FIRE ALARM SYSTEM: YES EXISTING FIRE SPRINKLERS: YES APN: 14820008 ZONING DISTRICT: P(40) SAN ANTONIO PRECISE PLAN		APPLICABLE CODES: BUILDING CODE: 2022 CALIFORNIA BUILDING CODE PART 2; VOLUME 1 AND 2 PLUMBING CODE: 2022 CALIFORNIA PLUMBING CODE MECHANICAL CODE: 2022 CALIFORNIA MECHANICAL CODE ELECTRICAL CODE: 2022 CALIFORNIA ELECTRICAL CODE ENERGY CODE: 2022 CALIFORNIA ENERGY CODE FIRE AND LIFE SAFETY CODE: 2022 CALIFORNIA FIRE CODE ACCESSIBILITY CODE: 2022 CALIFORNIA BUILDING CODE - CHAPTER 11B		SHEET #		DESCRIPTION		CD SET		REVISION 01		REVISION 02		REVISION 03		SHEET #		DESCRIPTION		PERMIT		REVISION 01		REVISION 02		REVISION 03	
LANDLORD CONTACT: CARMELO S. PHONE: 650-556-6143						GENERAL												MECHANICAL											
						T001 COVER SHEET T002 GENERAL NOTES & ABBREVIATIONS T003 GENERAL NOTES T004 ACCESSIBILITY DETAILS T005 ACCESSIBILITY DETAILS T006 CITY APPROVALS												M001 MECHANICAL GENERAL NOTES, SYMBOL LIST & ABBREVIATIONS M002 MECHANICAL SPECIFICATIONS M100 MECHANICAL FLOOR PLAN M500 MECHANICAL DETAILS M600 MECHANICAL SCHEDULES M700 TITLE 24 M701 TITLE 24 M702 TITLE 24											
						TOTAL : 6										TOTAL : 8													
SURVEYOR / ARCHITECT: CONTACT: GLADIRA NONATO ADDRESS: 20521 EARL STREET TORRANCE, CA 90503 PHONE: 310-283-3523 FAX: 775-890-0954 EMAIL: gnonato@menemshasolutions.com WEBSITE: https://www.menemshasolutions.com/		PROJECT SCOPE INTERIOR RETAIL TENANT IMPROVEMENT; INCLUDING NON-STRUCTURAL PARTITIONS, NEW DROP CEILING MILLWORK AND FINISHES. SCOPE ALSO INCLUDES THE REQUIRED MECHANICAL, ELECTRICAL, AND PLUMBING UPDATES. SIGNAGE UNDER SEPARATE SCOPE AND NOT INCLUDED IN THIS PERMITS SCOPE. NO EXTERIOR SCOPE INCLUDED UNDER THIS PERMIT.				ARCHITECTURAL												ELECTRICAL											
						A001 EXITING AND LIFE SAFETY PLAN A002 SITE PLAN AD101 DEMO FLOOR PLAN AD102 DEMO REFLECTED CEILING PLAN A101 FLOOR PLAN A111 FINISH PLAN A121 REFLECTED CEILING PLAN & LIGHTING SCHEDULE A221 INTERIOR ELEVATIONS A222 INTERIOR ELEVATIONS A223 INTERIOR ELEVATIONS A301 ENLARGED RESTROOM PLAN A501 DETAILS A502 DETAILS A503 DETAILS A601 DOOR SCHEDULE A602 FINISH SCHEDULE A603 EXISTING EXTERIOR ELEVATION												E001 ELECTRICAL SYMBOLS, ABBREVIATIONS & GENERAL NOTES E002 ELECTRICAL SPECIFICATIONS E003 ELECTRICAL SPECIFICATIONS E100 ELECTRICAL LIGHTING PLAN E200 ELECTRICAL POWER PLAN E300 ELECTRICAL RISER DIAGRAM & PANEL SCHEDULE E400 ELECTRICAL DETAILS E500 TITLE 24 E501 TITLE 24											
						TOTAL : 17										TOTAL : 9													
PROJECT COORDINATOR COMPANY: MENEMSHA CONTACT: CARLOS VILLECAS ADDRESS: 20521 EARL ST TORRANCE, CA, 90503 PHONE: 310-528-3717 EMAIL: cvillegas@menemshasolutions.com		JURISDICTION NOTES 1. STAMPING OF THESE PLANS AND SPECIFICATIONS IS NOT AN APPROVAL TO VIOLATE AND CITY POLICY OR ORDINANCE, COUNTY, STATE OR FEDERAL LAW. 2. MUST OBTAIN DEBRIS BOXES. PLEASE CONTACT RECOLOGY MOUNTAIN VIEW AT (650) 967-3034, OR THE CITY OF MOUNTAIN VIEW PUBLIC WORKS DEPARTMENT FOR REQUIREMENTS AT (650) 903-6311. 3. THE ORIGINAL JOB CARD AND APPROVED CONSTRUCTION PLANS MUST BE ON SITE AT TIME OF EACH INSPECTION. THE CONTRACTOR MUST BE PRESENT AT TIME OF FINAL INSPECTION.				DEFERRED SUBMITTALS		• FIRE SPRINKLER AND ALARM SYSTEM MODIFICATIONS. • SIGNAGE UNDER SEPARATE PERMIT BY SIGNAGE FABRICATOR										PLUMBING											
																P001 PLUMBING SYMBOLS, ABBREVIATION, AND NOTES P002 PLUMBING SPECIFICATIONS P101 PLUMBING FLOOR PLAN P201 PLUMBING DETAILS P202 PLUMBING RISER AND SCHEDULES P301 TITLE 24 P302 TITLE 24													
																TOTAL : 7													
MEP ENGINEER COMPANY: NEARBY ENGINEERS CONTACT: SANKEY ABHANG ADDRESS: 382 NE 191st St, SUITE 49674 MIAMI, FL 33179. PHONE: (646) 878-9217 EMAIL: sanket@ny-engineers.com																		VICINITY MAP PLAN											
		</td																											

NO.	DESCRIPTION	DATE
1	BUILDING DEPT. COMMENTS	05.15.25
2	BUILDING DEPT. COMMENTS	06.26.25
3	BUILDING DEPT. COMMENTS	07.25.25

GENERAL NOTES


SITE TO COMPLY WITH ALL ITEMS NOTED BELOW BY THE CITY OF MOUNTAIN VIEW

A. WALKWAYS AND SIDEWALKS ALONG ACCESSIBLE ROUTES OF TRAVEL (1) ARE CONTINUOUSLY ACCESSIBLE; (2) HAVE MAXIMUM 1/2" CHANGES IN ELEVATION OR PROVIDE CURB RAMPS COMPLYING WITH CBC 11B-406; (3) ARE MINIMUM 48" IN WIDTH AND (4) WHERE NECESSARY TO CHANGE ELEVATION AT A SLOPE EXCEEDING 5% (i.e., 1:20) SHALL HAVE PEDESTRIAN RAMPS COMPLYING WITH CBC 11B-405. CBC 11B-202.4, 11B-206.2.2, 11B-303.1, 11B-403.5, 11B-405 AND 11B-406.

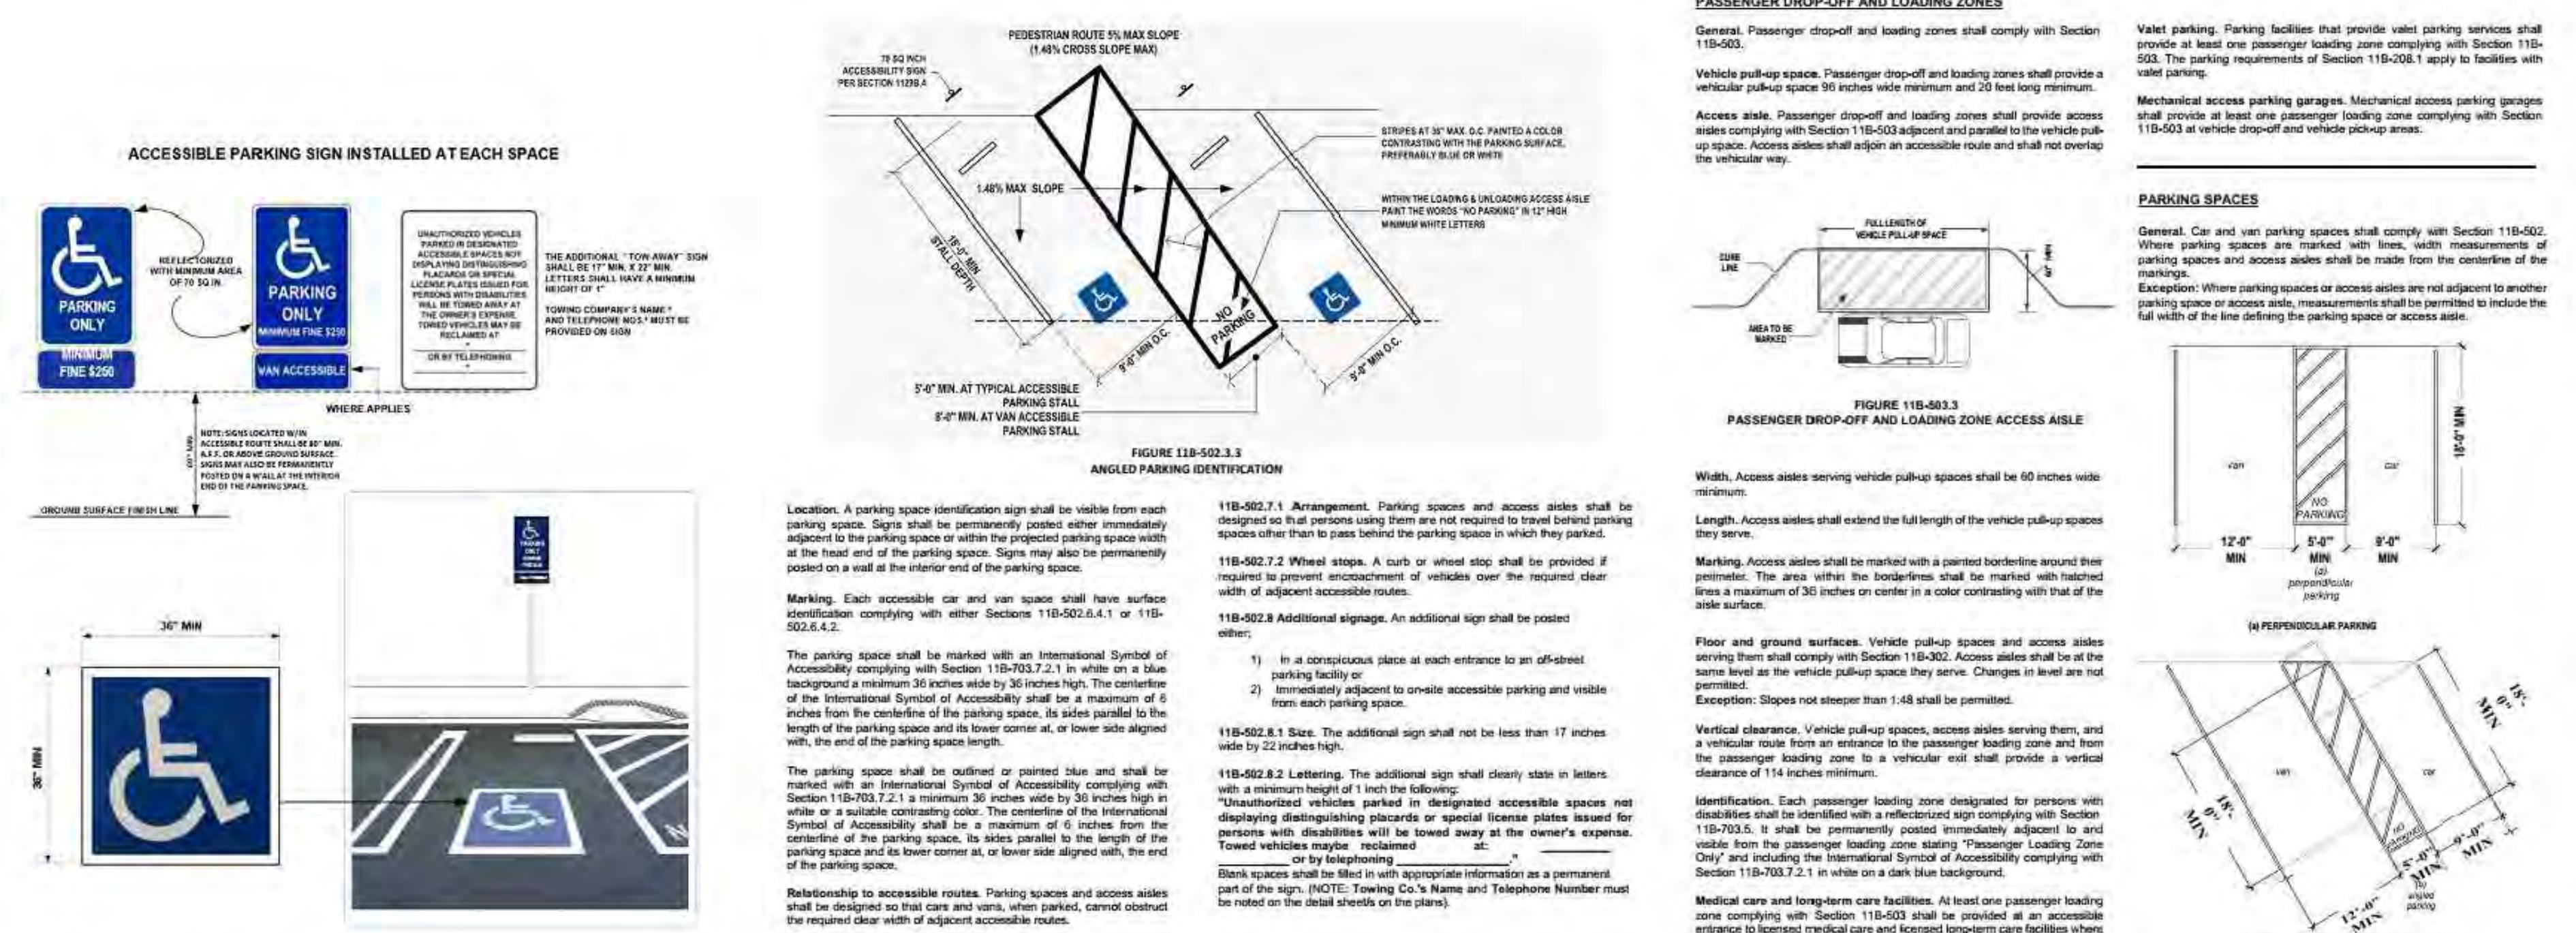

EXISTING ACCESSIBLE PARKING DETAILS

SCALE 1/2

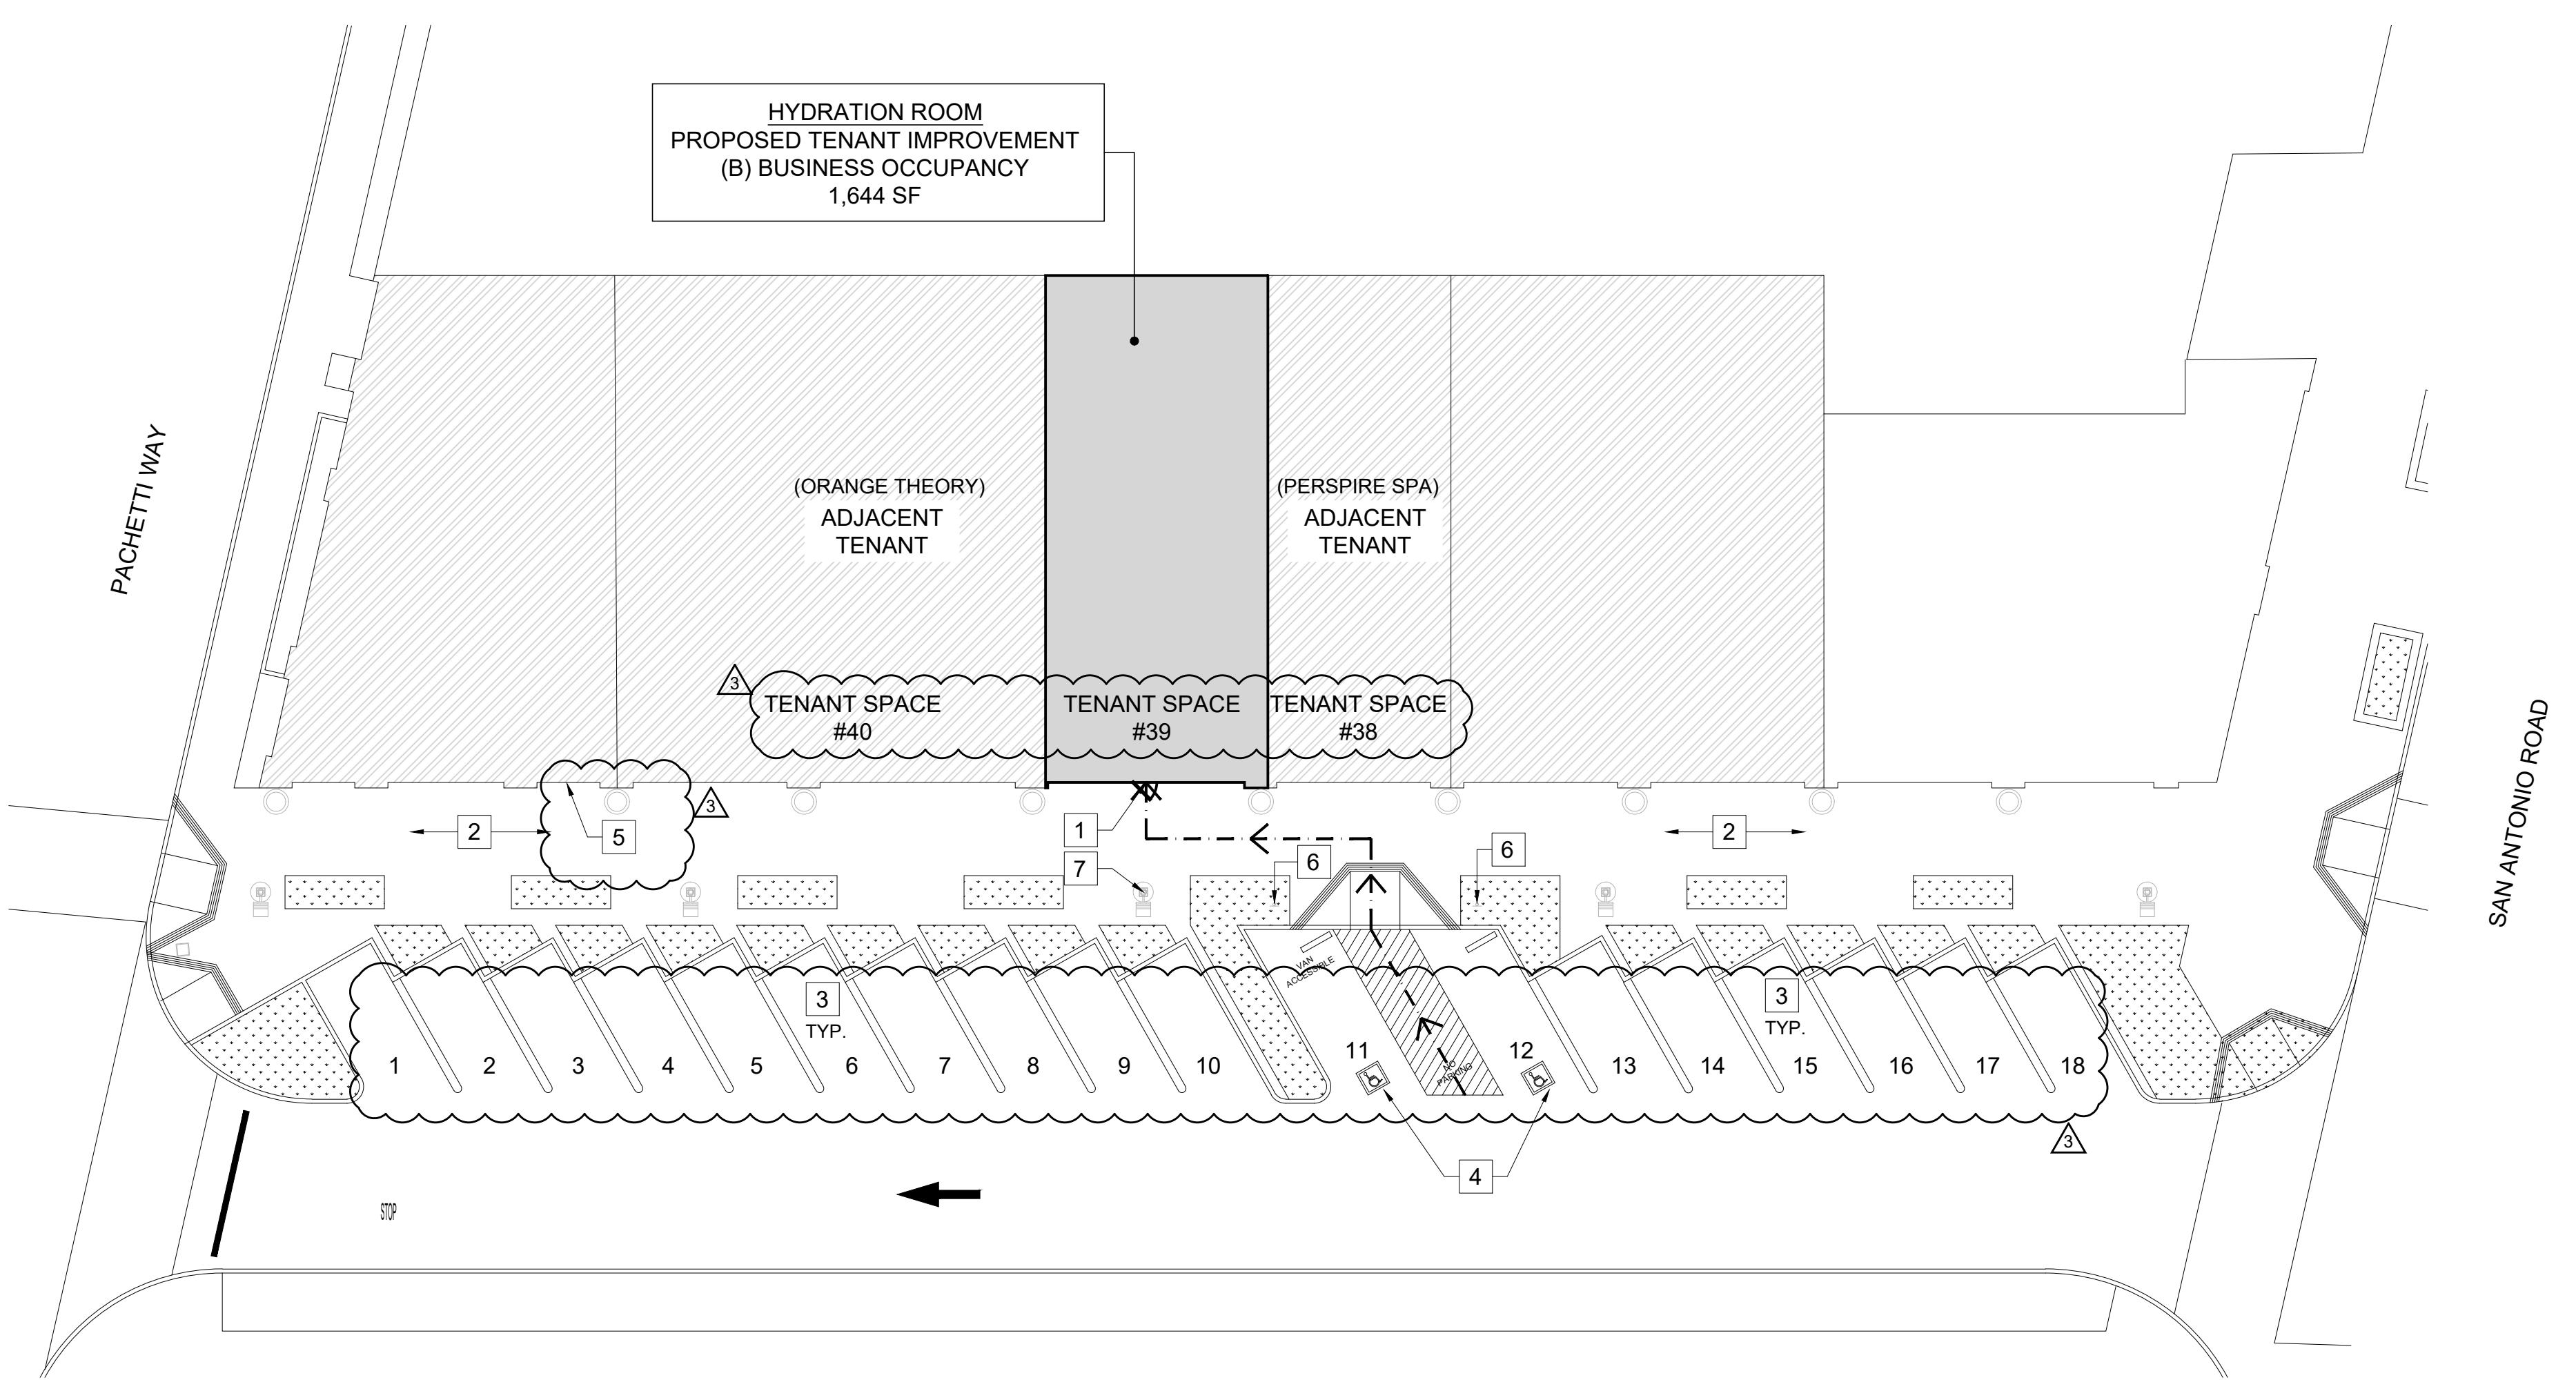

EXISTING SITE PLAN

SCALE 1/16=1'-0"

LEGEND


- ACCESSIBLE PATH OF TRAVEL
- SCOPE OF TENANT IMPROVEMENT
- LANDSCAPE & IRRIGATION (EXISTING)

GENERAL NOTES

SITE TO COMPLY WITH ALL ITEMS NOTED BELOW BY THE CITY OF MOUNTAIN VIEW

A. WALKWAYS AND SIDEWALKS ALONG ACCESSIBLE ROUTES OF TRAVEL (1) ARE CONTINUOUSLY ACCESSIBLE; (2) HAVE MAXIMUM 1/2" CHANGES IN ELEVATION OR PROVIDE CURB RAMPS COMPLYING WITH CBC 11B-406; (3) ARE MINIMUM 48" IN WIDTH AND (4) WHERE NECESSARY TO CHANGE ELEVATION AT A SLOPE EXCEEDING 5% (i.e., 1:20) SHALL HAVE PEDESTRIAN RAMPS COMPLYING WITH CBC 11B-405. CBC 11B-202.4, 11B-206.2.2, 11B-303.1, 11B-403.5, 11B-405 AND 11B-406.

NO.	DESCRIPTION	DATE
1	BUILDING DEPT. COMMENTS	05.15.25
2	BUILDING DEPT. COMMENTS	06.26.25
3	BUILDING DEPT. COMMENTS	07.25.25

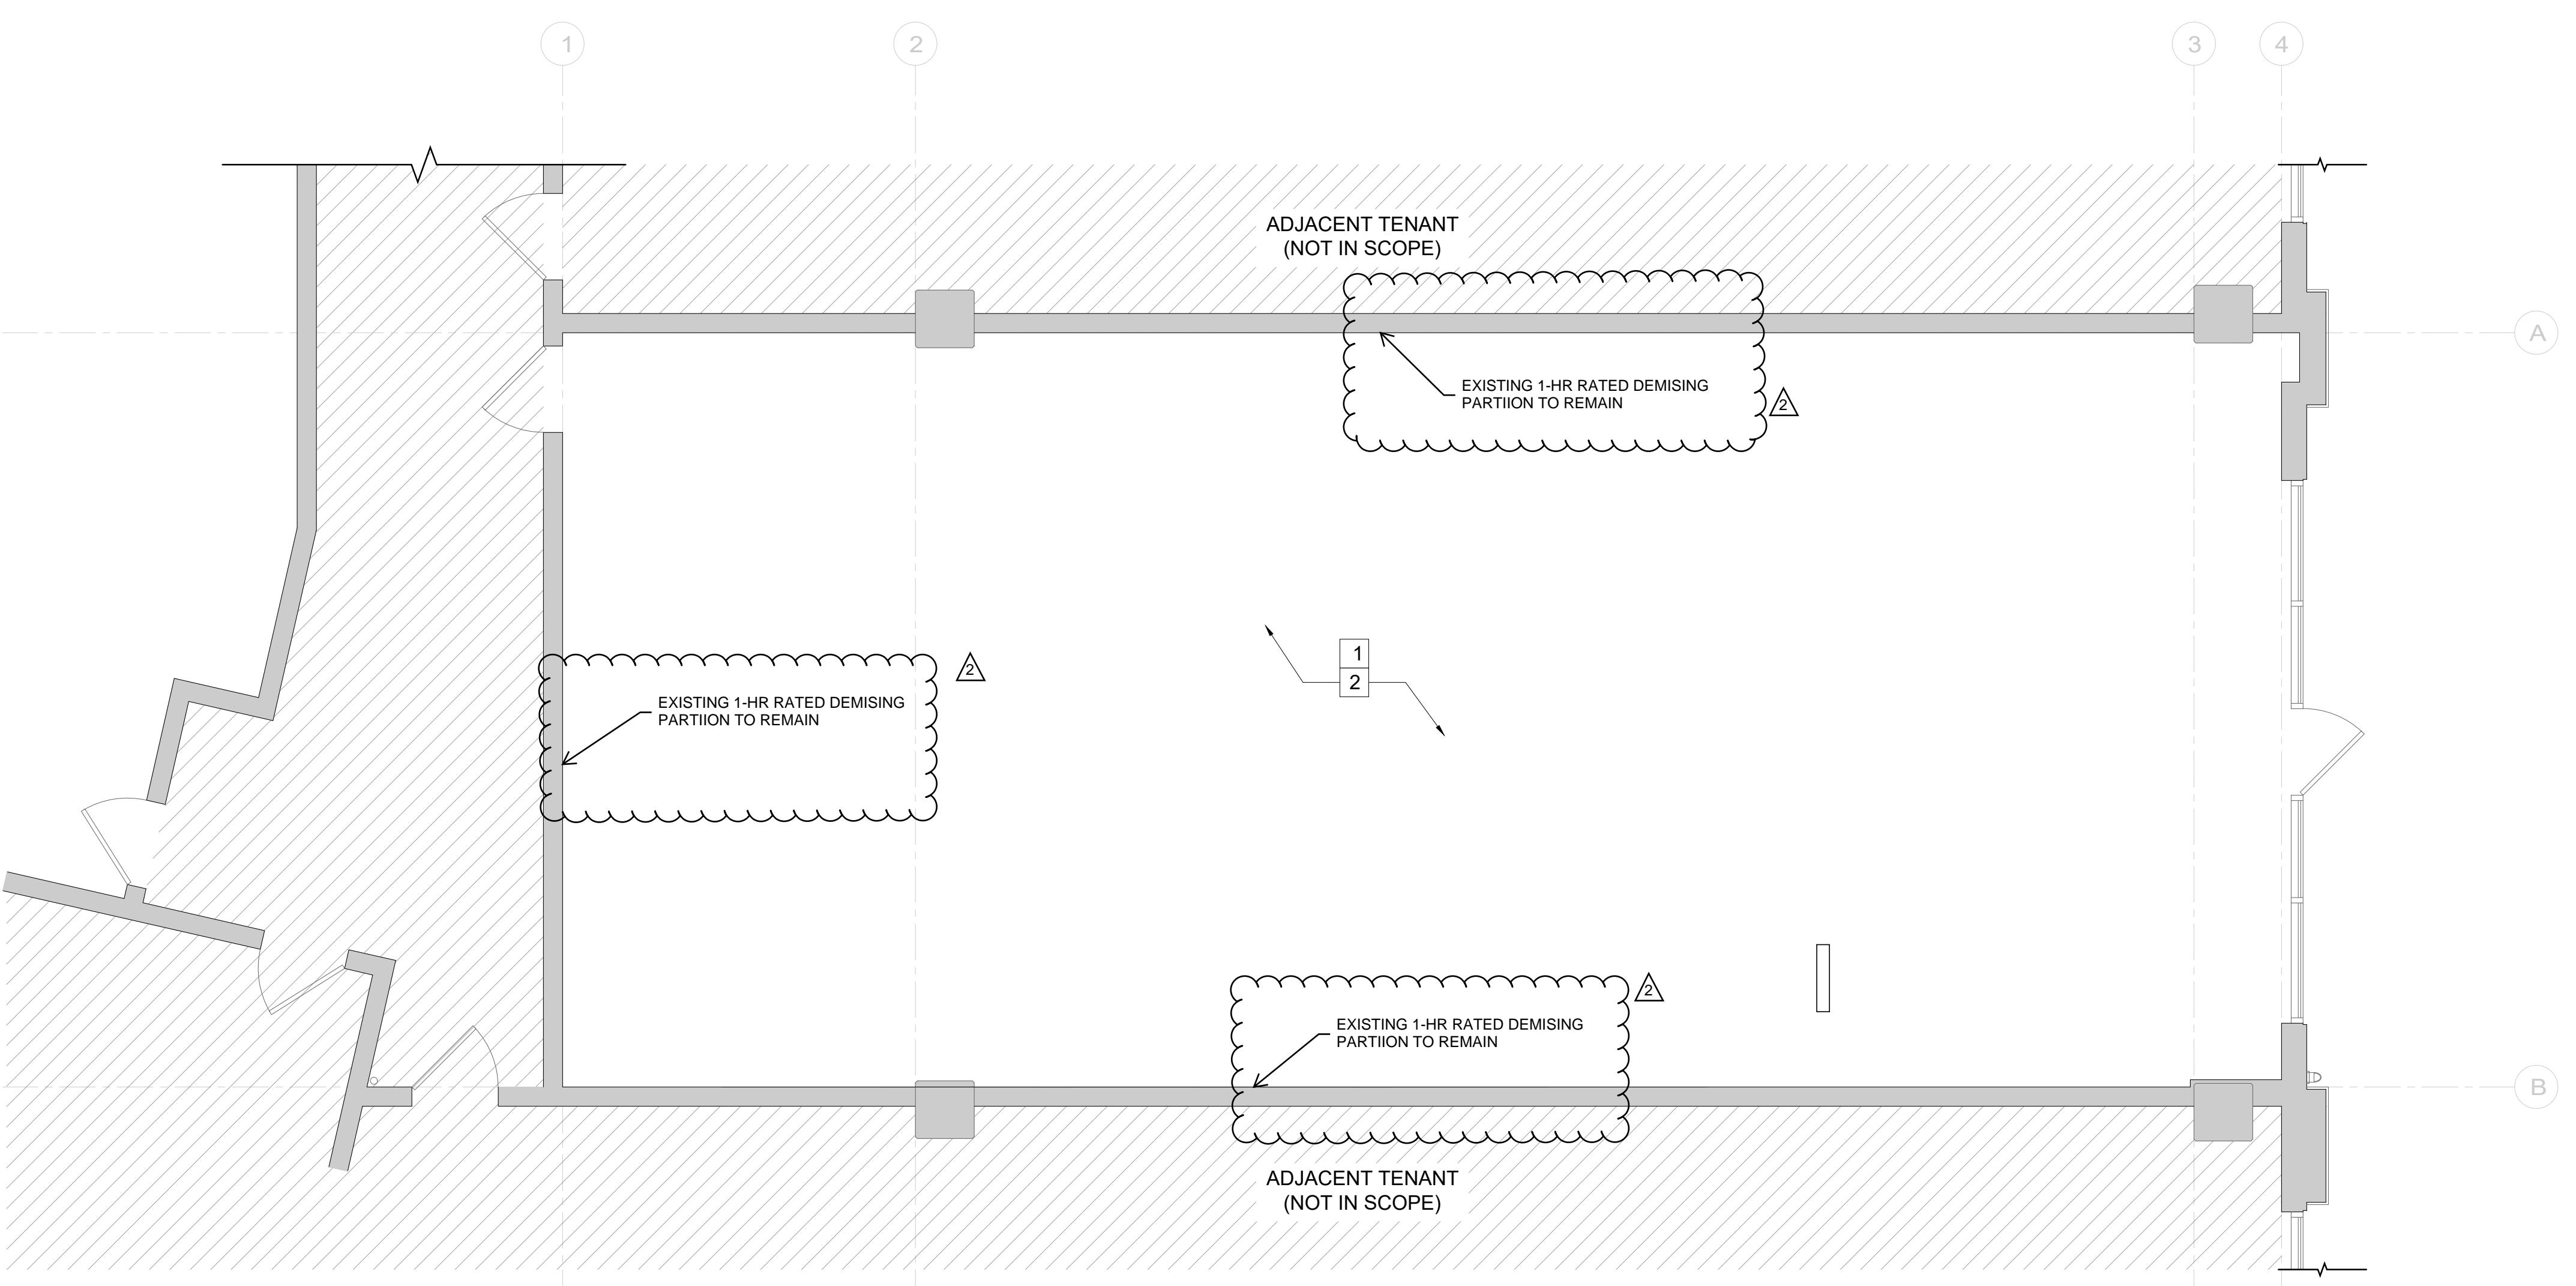

GENERAL NOTES

- A. DEMOLITION, SALVAGE, AND RECYCLING SHALL COMPLY WITH ALL APPLICABLE CODES, ORDINANCES, RULES, REGULATIONS OF THE COUNTY, AND STATE REQUIREMENTS.
- B. SEQUENCE OPERATION TO MAINTAIN SAFE WORKING CONDITIONS AND PRESERVE EXISTING WORK THAT IS TO REMAIN.
- C. ALL EXISTING CONDITIONS AND DIMENSIONS ON THE DRAWINGS ARE TO BE VERIFIED IN THE FIELD PRIOR TO PROCEEDING WITH ANY WORK.
- D. CONDUCT DEMOLITION TO MINIMIZE INTERFERENCE WITH ADJACENT AND OCCUPIED BUILDING AREAS, INCLUDING PUBLIC AND PRIVATE ACCESS TO ADJACENT ROADS, SIDEWALKS AND ALLEYS.
- E. PROVIDE AND MAINTAIN WEATHER PROTECTION AT EXTERIOR OPENINGS AS REQUIRED TO FULLY PROTECT THE INTERIOR PREMISES AGAINST DAMAGE FROM THE ELEMENTS UNTIL SUCH OPENINGS ARE CLOSED BY NEW CONSTRUCTION.
- F. DO NOT CUT OR REMOVE CONSTRUCTION WHICH MIGHT WEAKEN OR IMPAIR THE STRUCTURAL INTEGRITY OR STRENGTH OF THE STRUCTURAL FRAMING OR SUPPORT SYSTEMS WHICH ARE TO REMAIN.
- G. DESIGN, PROVIDE, ERECT AND MAINTAIN NECESSARY TEMPORARY SHORING, BRACING, FRAMING, OR SUPPORT AT LOAD BEARING STRUCTURAL ELEMENTS. TERMINATE ALL SUPPORTING MEMBERS ARE WEAKENED BY CUTS OR OPENINGS OR SUBJECT TO DAMAGE FROM DEMOLITION OPERATIONS AND OTHERWISE AS REQUIRED FOR SAFETY OR TO PROTECT FINISH SURFACES FROM DAMAGE.
- H. ALL BUILDING SYSTEMS MUST BE PROPERLY TERMINATED, REMOVED AND/OR CAPPED BY DEMOLITION PLENG AND WELDING IN A SAFE, CODE-CONFORMING AND PERMANENT MANNER. WHERE A PARTITION OR OTHER WORK IS NOTED TO BE REMOVED, REMOVE AND/OR TERMINATE ALL ELECTRICAL AND TELEPHONE OUTLETS, CONDUITS AND BOXES, LIGHT SWITCHES, THERMOSTATS, PLUMBING, DUCTWORK, MILLWORK AND ANY OTHER ATTACHED ITEMS.
- I. ALL LIFE SAFETY SYSTEMS SHALL REMAIN ACTIVE DURING DEMOLITION. THE SPACE SHALL BE MAINTAINED AND LEFT IN A SAFE CODE CONFORMING MANNER. ALL FLOOR OPENINGS, HAZARDS, AND UNSAFE CONDITIONS SHALL BE IDENTIFIED AND THE GENERAL CONTRACTOR SHALL PROVIDE PROPER NOTIFICATION AND OBSTACLES TO SECURE PUBLIC SAFETY.
- J. PROVIDE ADEQUATE FIRE PROTECTION IN ACCORDANCE WITH LOCAL FIRE DEPARTMENT REQUIREMENTS FOR THE DURATION OF THE PROJECT.
- K. FURNISH ALL LABOR AND MATERIALS / EQUIPMENT AS REQUIRED TO COMPLETE DEMOLITION AND REMOVAL OF ALL ITEMS AS INDICATED.
- L. FURNISH A SYSTEM OF TEMPORARY LIGHT AND POWER IN THE SPACE DURING CONSTRUCTION AS NECESSARY. IN PARTITIONS TO BE REMOVED, REMOVE ALL OUTLETS, SWITCHES, WIRES, THERMOSTATS, ETC. UP TO ABOVE CEILING AND PROTECT. REMOVE ELECTRIC WIRING BACK TO FIRST JUNCTION BOX.
- M. EXISTING SPRINKLER HEADS, SMOKE DETECTORS AND FIRE ALARM BOXES ARE TO PROTECTED, REPLACED OR RELOCATED AS REQUIRED DURING DEMOLITION. FIRE PROTECTION IS TO BE MAINTAINED AS REQUIRED BY THE CITY OF OCEANSIDE. ANY TIME THE FIRE PROTECTION SYSTEMS ARE OUT OF SERVICE, THE OCEANSIDE FIRE DEPARTMENT SHALL BE CONTACTED AND A FIRE WATCH IN PLACE UNTIL SERVICES ARE BACK IN SERVICE.
- N. EXISTING SMOKE DETECTOR, SPRINKLER HEAD, FIRE ALARM BOX OR SIMILAR DEVICE, INCLUDING THE ASSOCIATE WIRING SHALL BE DAMAGED DURING DEMOLITION AND SUBSEQUENT CONSTRUCTION, RELOCATION OF SMOKE DETECTORS, AND FIRE ALARM EQUIPMENT, NECESSITATED BY NEW CONSTRUCTION, SHALL BE ACCOMPLISHED AS A FIRST PRIORITY, AND PER THE PLANS, NO ACTIVE SMOKE DETECTOR OR SPRINKLER HEAD SHALL BE COVERED OR OTHERWISE REMOVED OR USED FOR OTHER THAN ITS INTENDED PURPOSE.
- U. DEMOLITION IS NOT NECESSARILY LIMITED TO WHAT IS SHOWN DRAWINGS. THE INTENT IS TO INDICATE THE GENERAL SCOPE OF DEMOLITION REQUIRED TO COMPLETE THE WORK IN ACCORDANCE WITH THE CONTRACT DRAWINGS.
- V. ALL EXITS MUST REMAIN ACCESSIBLE AT ALL TIMES DURING DEMOLITION, AND EGRESS PATHS SHALL BE CLEAR OF DEBRIS.
- W. THE GENERAL CONTRACTOR IS TO COORDINATE DUMPSTER LOCATION, CONSTRUCTION TRAFFIC, BUILDING ACCESS, MATERIAL STAGING AREA, ETC. WITH THE CITY OF OCEANSIDE AS REQUIRED.
- X. G.C. TO PATCH AND REPAIR ANY AND ALL AREAS AFFECTED BY DEMOLITION. G.C. TO PROVIDE A CLEAN AND SMOOTH SUBSTRATE FOR INSTALLATION OF NEW FINISH MATERIALS, THIS INCLUDES FLOORS CORES, G.C. IS TO GRIND CORE PATCH TO A SMOOTH LEVEL SURFACE READY TO RECEIVE CARPET OR TILE.
- Y. WHERE EXISTING TILE, RESILIENT FLOORING OR OTHER SIMILAR ADHESIVES OR MORTAR APPLIED FINISHES ARE REQUIRED TO BE REMOVED: GRIND, SAND OR OTHERWISE REMOVE ALL ADHESIVES, MORTAR, FASTENERS AND SIMILAR MATERIALS TO THE EXTENT THAT NO RIDGES, LUMPS OR OTHER PROTRUSIONS WILL TELEGRAPH THROUGH THE SURFACE OF NEW FINISHES OR BE APPARENT WHEN THE SUBSTRATE IS LEFT EXPOSED.
- Z. EXERCISE EXTREME CARE IN CONTAINING DUST AND DEBRIS WITHIN THE CONTRACT AREA. PROVIDE A DUST PROOF BARRIER AROUND AREAS OF CONSTRUCTION FOR DURATION OF WORK.
- AA. REMOVE DEBRIS AS WORK PROGRESSES. UPON COMPLETION OF WORK, LEAVE AREAS IN CLEAN CONDITION, INCLUDING ADJACENT IMPROVEMENTS SCHEDULED TO REMAIN.
- BB. DISCONNECT, CAP, AND SEAL EXISTING UTILITIES AS NEEDED.

KEY NOTES

EXISTING EXTERIOR WALL OR NON-BEARING DEMISING PARTITION COMMON WITH ADJACENT SUITE. PATCH AND REPAIR GYPSUM BOARD FINISH WHERE REQUIRED DUE TO DEMOLITION, WHERE GYPSUM BOARD IS DAMAGED OR WHERE SCHEDULED SERVICES ARE TO BE INSTALLED IN WALL CAVITIES TO MATCH SMOOTH WALL FINISH READY FOR SCHEDULED PAINT FINISH.

1 (E) FLOORING TO BE PREPARED AND REPAIRED WHERE REQUISIT FOR (N) FLOOR FINISH

PERMIT SET
Issue Date:
05.08.25

Revisions:

... DESCRIPTION DATE

1 BUILDING DEPT. COMMENTS 5.15.25

2 BUILDING DEPT. COMMENTS 6.26.25

GENERAL NOTES

1. DIMENSIONS TAKE PRECEDENCE OVER SCALE ON THE CONSTRUCTION DOCUMENTS. DO NOT SCALE THE DRAWINGS. NOTIFY THE ARCHITECT OF DISCREPANCIES BETWEEN DRAWING CONDITIONS AND FIELD CONDITIONS.
2. INTERIOR PARTITIONS ARE DIMENSIONED TO THE FACE OF THE FINISHED WALL UNLESS NOTED OTHERWISE.
3. DIMENSIONS FROM ANY CORNER OR WALL TO FRAMING STUD AT A DOOR JAMB OPENING IS TO BE 4 INCHES UNLESS NOTED OTHERWISE.
4. PROVIDE BLOCKING FOR ALL WALL MOUNTED EQUIPMENT AND ACCESSORIES. PROVIDE FIRE-RESISTANT BLOCKING WHEN REQUIRED BY CODE.
5. ALL PARTITIONS WITH SINKS AND / OR WET EQUIPMENT, ALL WALLS IN TOILET ROOMS AND ALL WALLS IN KITCHEN AREAS TO HAVE 5/8" CEMENT BOARD TO MINIMUM 1'-0" FROM THE FLOOR. THE BALANCE OF WALL SHEATHING IN WET AREAS IS TO BE 5/8" TYPE "X" WATER RESISTANT GYPSUM BOARD UNLESS NOTED OTHERWISE.
6. ALL MILLWORK / PUBLIC SERVICE COUNTERS TO BE 34" AFF MAXIMUM.
7. CONTRACTOR SHALL BE RESPONSIBLE FOR MAINTAINING INTEGRITY OF RATED PARTITIONS AND STRUCTURES INCLUDING ALL PENETRATIONS AS REQUIRED BY OTHERS TRADES.
8. REFER TO FINISH SCHEDULE AND DETAILS FOR APPLIED WALL, CEILING AND FLOOR FINISHES.

Stamp:



Project Owner:



Project Address:

 HYDRATION ROOM
 555 SAN ANTONIO ROAD
 SUITE #39
 MOUNTAIN VIEW, CA 94040

CITY DATE AND APPROVAL STAMP

CITY DATE AND APPROVAL STAMP

PERMIT SET

Issue Date:

05.08.25

Revisions:

...	DESCRIPTION	DATE
1	BUILDING DEPT. COMMENTS	5.15.25
2	BUILDING DEPT. COMMENTS	6.26.25

Principal In Charge:

DARUSSZ K. WIECHA

Project Manager:

CARLOS VILLEGAS

Drawn By:

AEC


Project Number 27998

Sheet Title:


FLOOR PLAN

Sheet Number:

A101

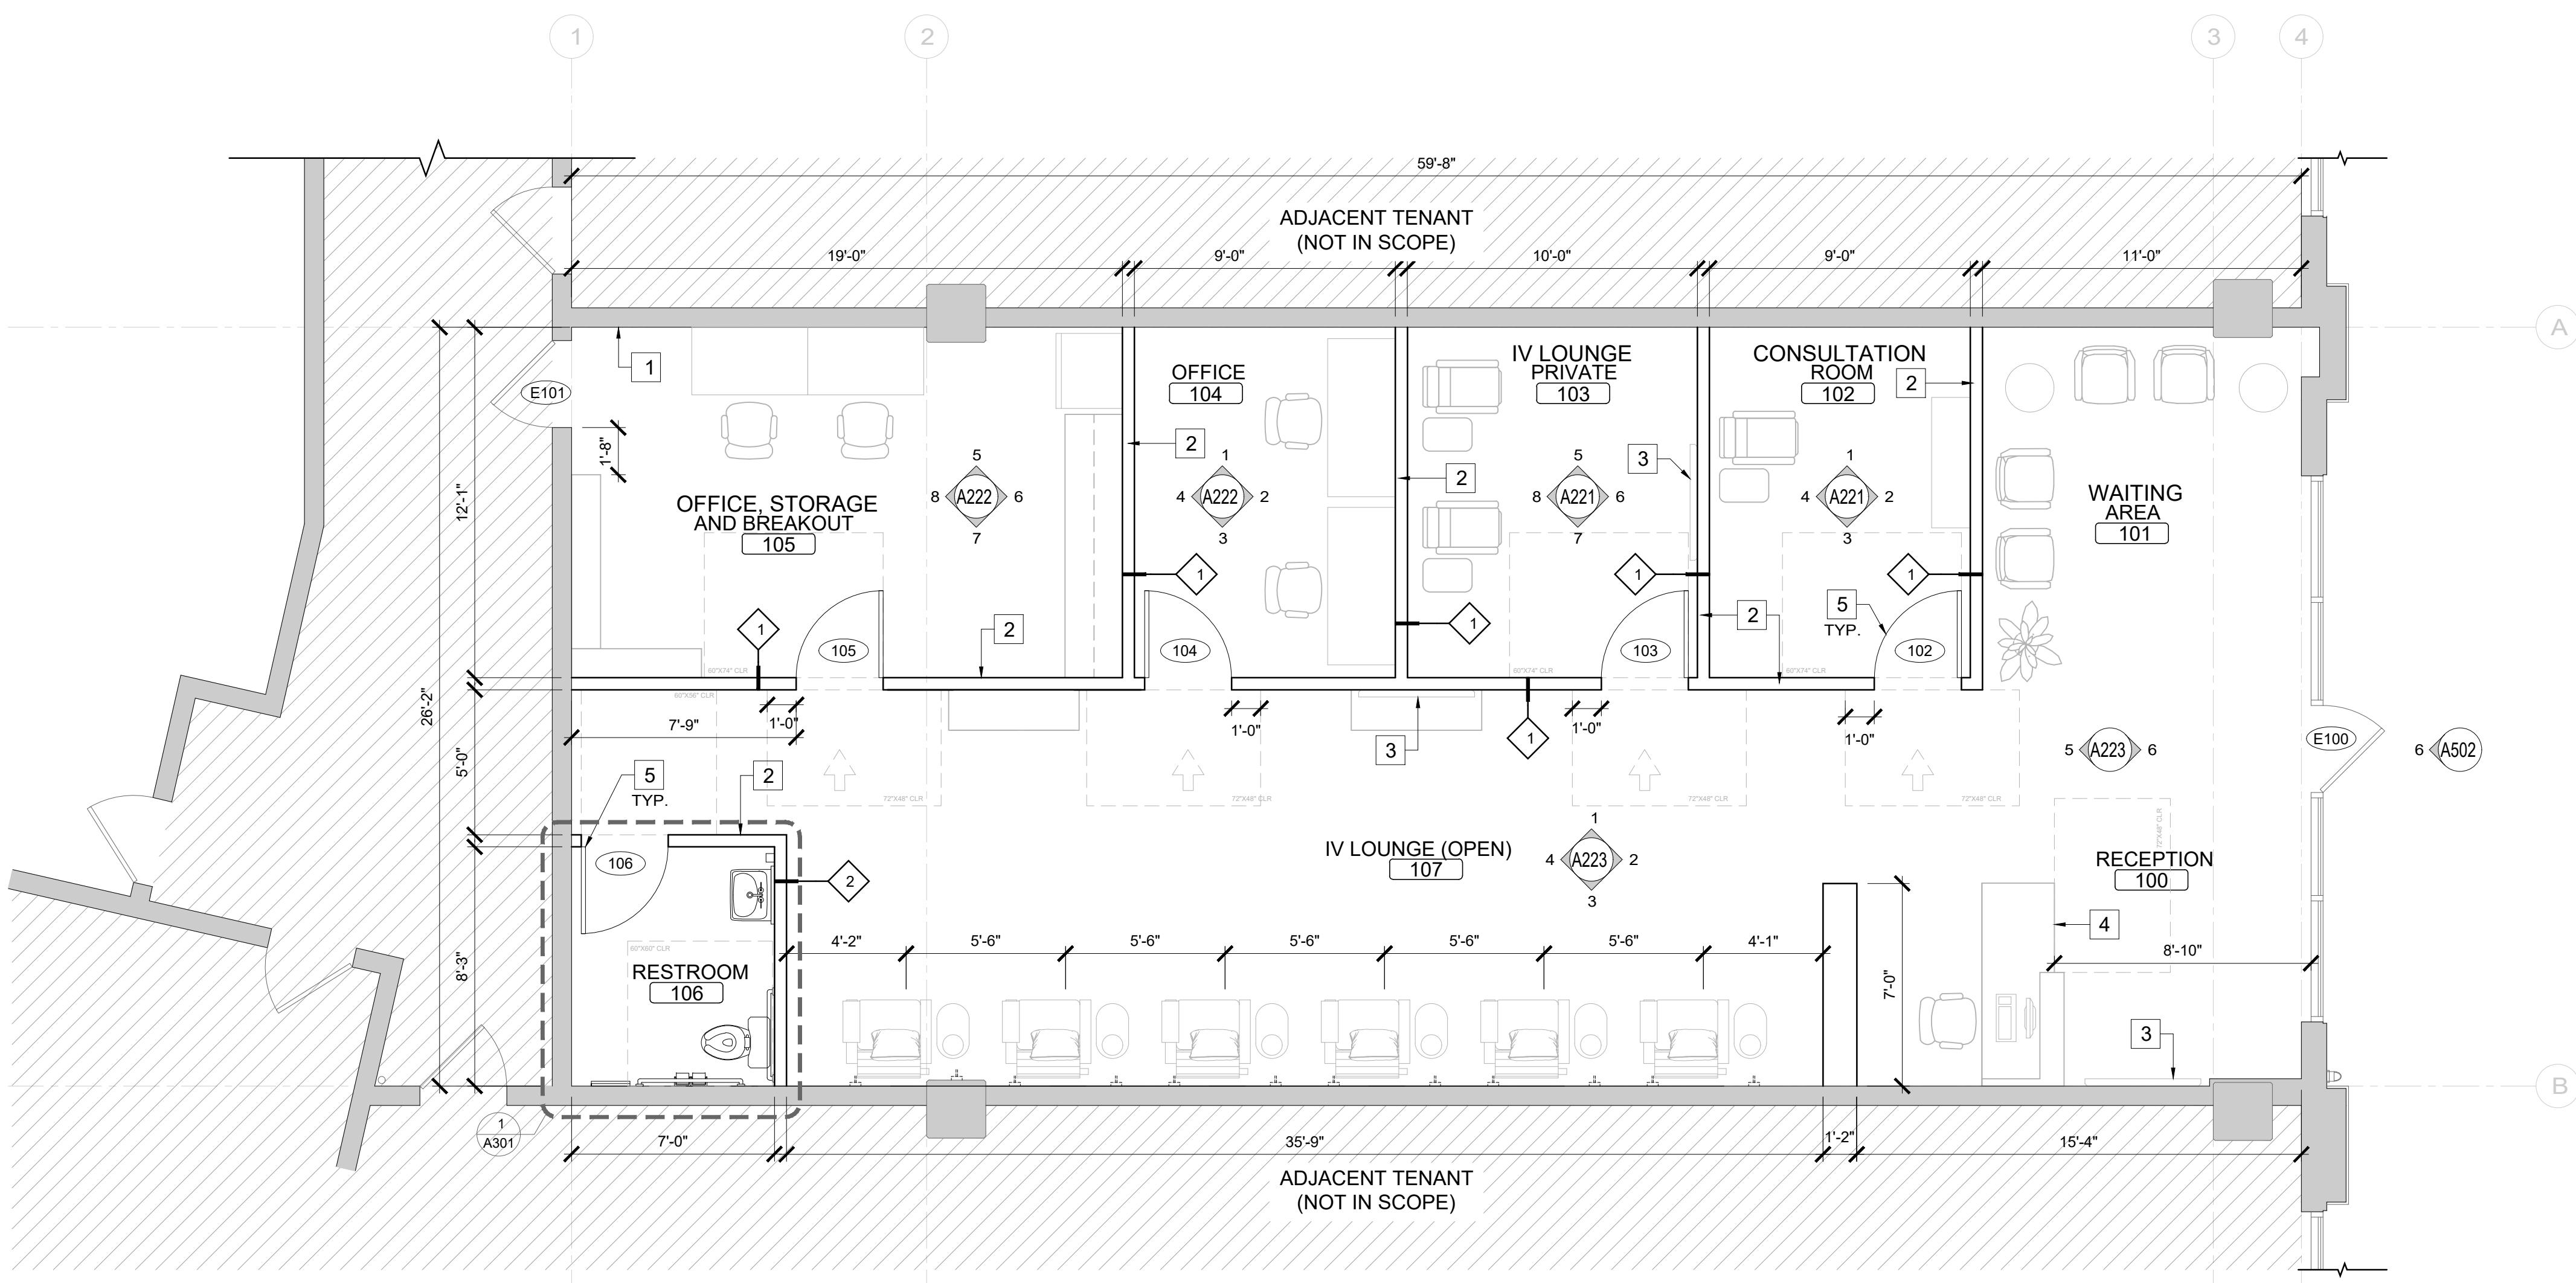
KEY NOTES

- 1 EXISTING EXTERIOR WALL OR NON-BEARING DEMISING PARTITION COMMON WITH ADJACENT SUITE. PATCH AND REPAIR GYPSUM BOARD FINISH WHERE REQUIRED DUE TO DEMOLITION, WHERE GYPSUM BOARD IS DAMAGED OR WHERE SCHEDULED SERVICES ARE TO BE INSTALLED IN WALL CAVITIES TO MATCH SMOOTH WALL FINISH READY FOR SCHEDULED PAINT FINISH.
- 2 NEW 3 5/8" METAL STUD INTERIOR WALL PARTITION. USE 6" METAL STUD AS REQUIRED AT RESTROOM DOOR WALL TO ALIGN WITH EXISTING CONSTRUCTION. INSTALL R-13 BATT INSULATION IN CAVITIES FOR SOUND ATTENUATION BETWEEN ROOMS OR AREAS. SEE DETAILS - FOR STUD GAUGES, SPACING AND ADDITIONAL NOTES AND INFORMATION.
- 3 PROPOSED LOCATION FOR TENANT-PROVIDED AND INSTALLED MONITOR TV. COORDINATE ALL LOCATIONS, MOUNTING HEIGHTS, SERVICE REQUIREMENTS, AND MONITOR SIZE AND WEIGHT WITH TENANT. IF REQUIRED, PROVIDE ADEQUATE BACKING FOR MONITOR BRACKET.
- 4 TENANT-SUPPLIED FURNITURE / SERVICE COUNTER. A PORTION OF THE SERVICE COUNTER SHALL BE AT LEAST 36 INCHES LONG WITH A MAXIMUM HEIGHT IF 34 INCHES ABOVE FINISHED FLOOR, IN COMPLIANCE WITH C.B.C. 11B-904.4.
- 5 ALL DOORS TO BE INSTALLED WITH A 4" OFFSET FROM ADJACENT PERPENDICULAR WALLS, UNLESS NOTED OTHERWISE. COORDINATE WITH DOOR FRAME TYPES, SWING CLEARANCES, AND ADJACENT FINISHES.

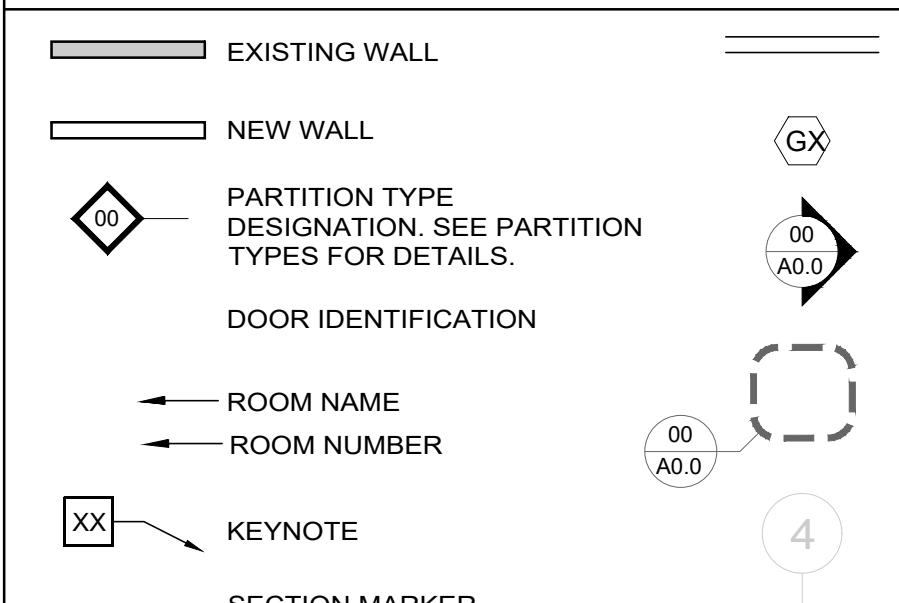LEGEND

PARTITION LEGEND

	EXISTING PARTITION (1-HR RATED)
	NEW PARTITION (NON RATED)

GENERAL NOTES

1. NO MATERIAL SUBSTITUTIONS TO BE MADE WITHOUT APPROVAL FROM ARCHITECT AND/OR OWNER'S REPRESENTATIVE.
2. INSTALL FRP PANELS COMPLETE WITH ALL TRIM AND ACCESSORIES PER MANUFACTURER'S INSTRUCTIONS.
3. PROVIDE PROPER PROTECTION AGAINST DAMAGE TO ALREADY INSTALLED FIXTURES, FURNITURE, ADJACENT FINISHED WORK OR FLOORING.
4. ALL CRACKS, HOLES OR OTHER IMPERFECTIONS IN EXISTING GYPSUM BOARD SURFACES ARE TO BE PATCHED AND REPAIRED AS REQUIRED TO RECEIVE SCHEDULED FINISHES.
5. ALL PAINTED SURFACES TO RECEIVE (1) COAT PRIMER AND (2) COATS FINISH PAINT (MINIMUM) WITH ADDITIONAL COATS AS REQUIRED FOR PROPER COVERAGE.
6. PAINT CEILING OR SIGNAGE ACCESS PANELS TO MATCH ADJACENT FINISHES WHERE REQUIRED.
7. WALL COVERINGS TO BE INSTALLED ACCORDING TO MANUFACTURER'S SPECIFICATIONS: PREPARE, CLEAN AND PRIME SUBSTRATE AS REQUIRED.
8. PREPARE, CLEAN AND LEVEL THE EXISTING CONCRETE SLAB TO RECEIVE FLOORING FOR A FLUSH, SMOOTH FINISH.
9. SEAL ALL PENETRATIONS OF WALLS THAT ARE OPEN TO THE UNDERSIDE OF THE STRUCTURAL DECK.
10. REFER TO THE PLUMBING DRAWINGS FOR ALL FLOOR DRAINS AND FLOOR SINKS.
11. THE CONTRACTOR WILL BE RESPONSIBLE FOR COORDINATING DELIVERY LEAD TIMES FOR ALL FINISH MATERIALS.

KEY NOTES

1 REFER TO FINISH SCHEDULE FOR PAINT SPECIFICATIONS



Project Owner:



Project Address:

HYDRATION ROOM
555 SAN ANTONIO ROAD
SUITE #39
MOUNTAIN VIEW, CA 94040

CITY DATE AND APPROVAL STAMP

CITY DATE AND APPROVAL STAMP

PERMIT SET

Issue Date:

05.08.25

Revisions:

...	DESCRIPTION	DATE

Principal In Charge:

DARUSZ K. WIECHA

Project Manager:

CARLOS VILLEJAS

Drawn By:

AEC

Project Number 27998

Sheet Title:


FINISH PLAN

Sheet Number:

A111

SYMBOL LEGEND

WC-04	WALL FINISH: LINE INDICATES EXTENT OF FINISH
	FLOOR TRANSITION

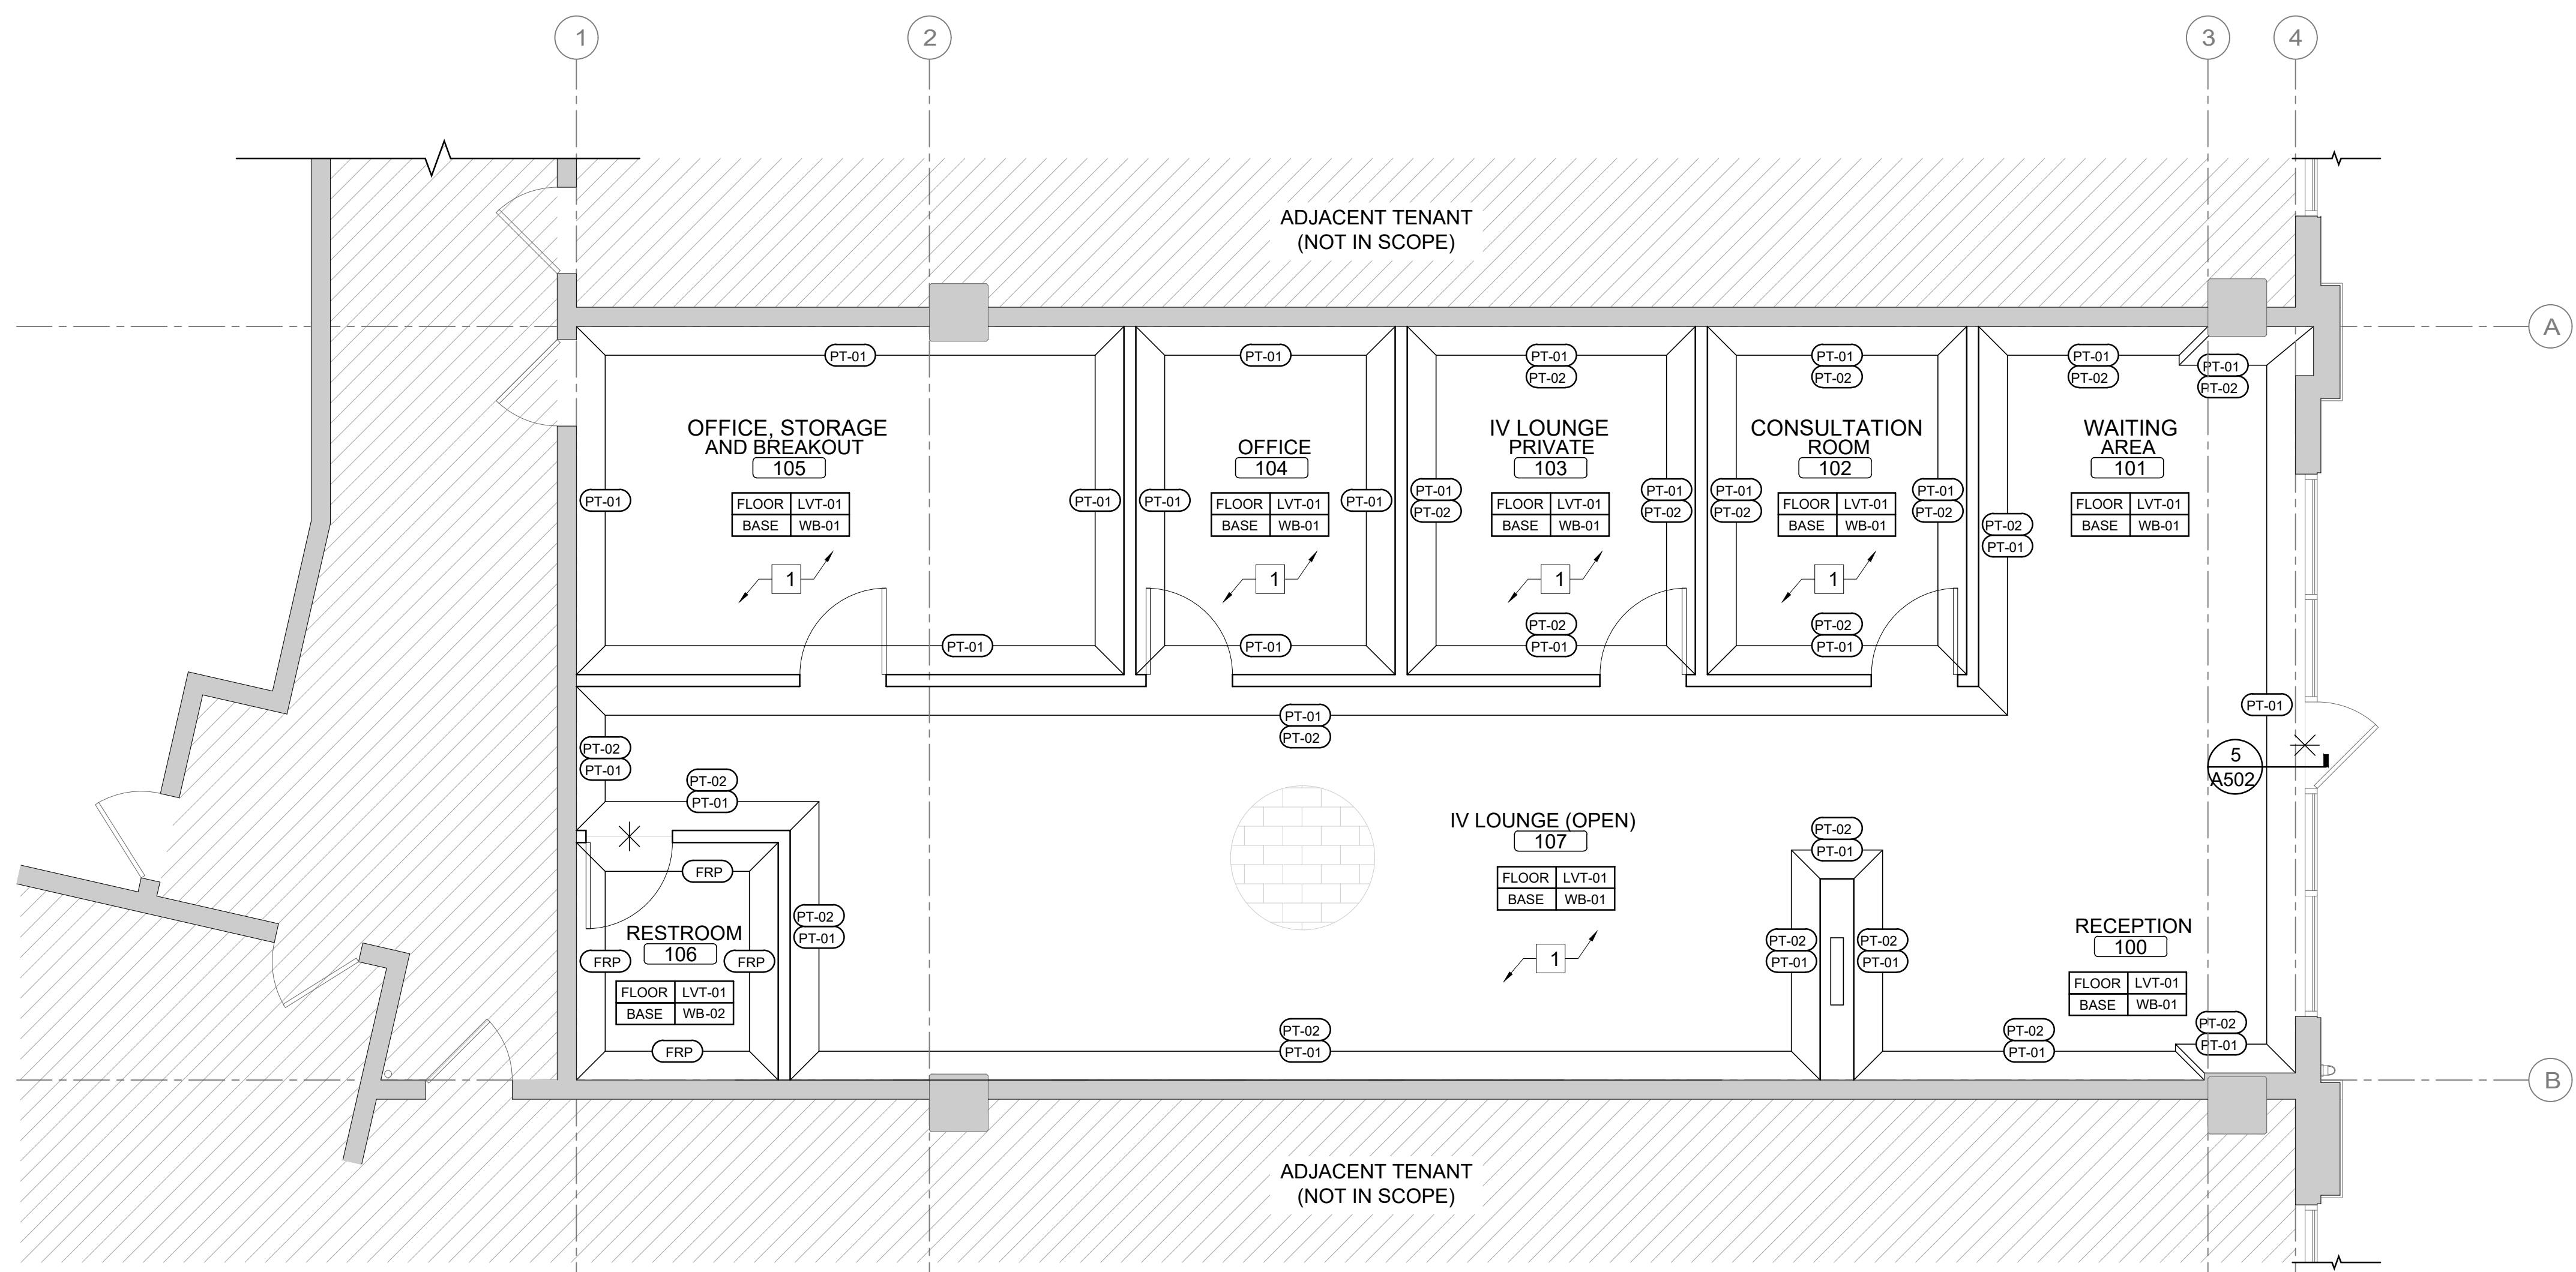

GENERAL NOTES

1. REFER TO SHEET A602 FOR FINISH SCHEDULE.
 2. TARGET ELEVATIONS ARE TAKEN FROM PROJECT FINISH FLOOR (+0'-0").
 3. REFER ALSO TO THE REFLECTED CEILING PLAN FOR ADDITIONAL INFORMATION ON LIGHTING FIXTURES / MOUNTING HEIGHTS.

KEY NOTES

1 DOOR ASSEMBLY AS SCHEDULED.
 2 LINE OF SCHEDULED FLOOR BASE
 3 WHITE BOARD TO BE INSTALLED ON BACK SIDE (OFFICE SIDE) OF DOOR, VERTICAL PLACEMENT. CONFIRM HEIGHT AND INSTALLATION WITH TENANT. VIZ-PRO MAGNETIC DRY ERASE BOARD, 24"X36", SILVER ALUMINUM FRAME
 4 PROPOSED LOCATION FOR TENANT PROVIDED AND INSTALLED MONITOR TV. COORDINATE ALL LOCATIONS, MOUNTING, HEIGHT, SERVICE REQUIREMENTS, AND MONITOR SIZE AND WEIGHT. IF REQUIRED PROVIDE BACKING FOR TENANT PROVIDED MONITOR BRACKET PER DETAIL # 16/A501
 5 PROVIDE FRAMED AND DRYWALLED RECESSED NICHE AT ALL WALL-MOUNTED TV LOCATIONS, SIZE TO ACCOMMODATE TV BACKING PLATE AND CABLE MANAGEMENT (TYP. 14" X 14"). INCLUDE SINGLE GANG POWER OUTLET.

NOT USED **8** **INTERIOR ELEVATION** **6**

NOT USED **7** **INTERIOR ELEVATION** **5**

INTERIOR ELEVATION **4** **INTERIOR ELEVATION** **3**

INTERIOR ELEVATION **2** **INTERIOR ELEVATION** **1**

NOT USED **8** **INTERIOR ELEVATION** **6**

NOT USED **7** **INTERIOR ELEVATION** **5**

INTERIOR ELEVATION **4** **INTERIOR ELEVATION** **3**

INTERIOR ELEVATION **2** **INTERIOR ELEVATION** **1**

Project Address:
 HYDRATION ROOM
 555 SAN ANTONIO ROAD
 SUITE #39
 MOUNTAIN VIEW, CA 94040

CITY DATE AND APPROVAL STAMP

CITY DATE AND APPROVAL STAMP

PERMIT SET

Issue Date:
 05.08.25

Revisions:

...	DESCRIPTION	DATE

Principal In Charge:
 DARIUSZ K. WIECHA

Project Manager:
 CARLOS VILLEGAS

Drawn By:
 AEC

Project Number 27998

Sheet Title:
 INTERIOR ELEVATIONS

Sheet Number:
 A223

Architect:
Menemsha
 ARCHITECTURE
 A California Corporation

LOS ANGELES OFFICE
 20521 EARL STREET
 TORRANCE, CA 90503
 T. 310-343-3430

BOSTON OFFICE
 169 LIBBET PARKWAY
 WEYMOUTH, MA 02189
 T. 781-337-9012
 www.menemshasolutions.com

Plans, maps, specifications, studies, and reports not containing a wet ink seal imprint accompanied by an original signature by the licensed professional may have been fraudulently altered and shall not be considered an original. Any information should be disregarded unless verified by the professional whose signature appears above. All drawings and written material appearing herein constitute original and unpublished work of the architect and may not be duplicated, used or disclosed without written consent of the architect. Copyright Protected 2016.

Stamp:


Project Owner:
HYDRATION ROOM
 IV AND INJECTION THERAPY

Architect:

Menemsha
SOLUTIONSLOS ANGELES OFFICE
20521 EARL STREET
TORRANCE, CA 90503
T. 310-343-3430BOSTON OFFICE
91 LONGWATER CIRCLE
NORWELL, MA 02061
T. 781-337-9012
www.menemshasolutions.com

Plans, maps, specifications, studies, and reports not containing a wet ink seal imprint accompanied by an original signature by the licensed professional may have been electronically transmitted and may be considered an original copy. All information should be disregarded unless verified by the professional whose signature appears above. All drawings and written material appearing herein are the original and unpublished work of the architect and may not be duplicated, used or disclosed without written consent of the architect. Copyright Protected 2016



Project Owner:

 HYDRATION ROOM
IV AND INJECTION THERAPY

Project Address:
HYDRATION ROOM
555 SAN ANTONIO ROAD
SUITE #39
MOUNTAIN VIEW, CA 94040

CITY DATE AND APPROVAL STAMP 2

CITY DATE AND APPROVAL STAMP

PERMIT SET

Issue Date:
05.08.25

NO.	DESCRIPTION	DATE
1	BUILDING DEPT. COMMENTS	05.15.25
2	BUILDING DEPT. COMMENTS	06.26.25
3	BUILDING DEPT. COMMENTS	07.25.25

Principal In Charge:
DARUSZ K. WIECHA

Project Manager:
CARLOS VILLEGAS


Drawn By:
AEC

Project Number 27998

Sheet Title:
EXTERIOR ELEVATIONS


Sheet Number:
A603

EXISTING EXTERIOR ELEVATION 1
SCALE 1/4" = 1'-0"

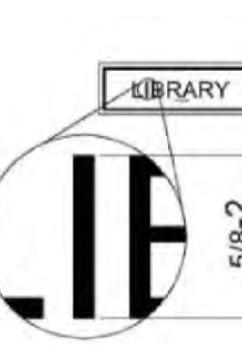

11B-703 Signs
11B-703.1 General. Signs shall comply with Section 11B-703. Where both visual and tactile characters are required, either one sign with both visual and tactile characters, or two separate signs, one with visual, and one with tactile characters, shall be provided.
11B-703.1.1 Plan review and inspection. Signs as specified in Section 11B-703, or in other sections of this code, when included in the construction of new buildings or facilities, or when included in the plans for alterations, additions, alterations or renovations to existing buildings or facilities, and when a permit is required, shall comply with Sections 11B-703.1.1 and 11B-703.1.2.
11B-703.1.2 Inspection. Signs and identification devices shall be visually inspected after completion of the work and prior to the issuance of a certificate of occupancy per Chapter 1, Division II, Section 111, or final approval where no certificate of occupancy is issued. The inspection shall include, but not be limited to, verification that Braille dots and cells are properly spaced and the size, proportion and type of raised characters are in compliance with these regulations.

TABLE 11B-703.1 BRILLE DIMENSIONS	
MEASUREMENT RANGE	MINIMUM IN INCHES MAXIMUM IN INCHES
Dot base diameter	0.059 - 0.063
Distance between two dots in the same cell	0.100
Distance between corresponding dots in adjacent cells	0.300
Dot height	0.028 - 0.037
Distance between corresponding dots from one cell directly below	0.365 - 0.400

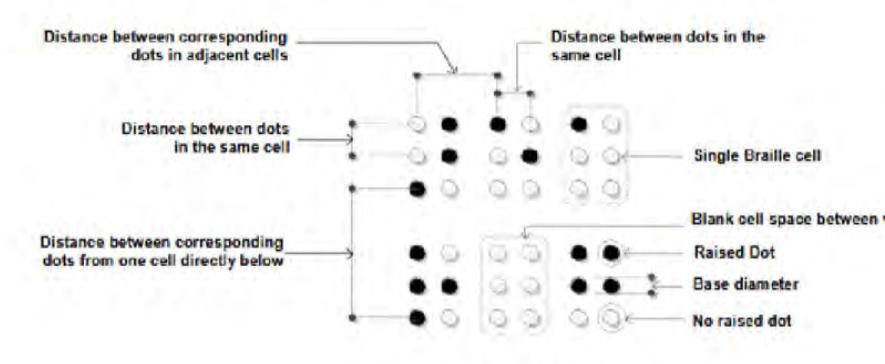FIGURE 11B-703.3.1
BRILLE MEASUREMENTFIGURE 11B-703.7.2.1
INTERNATIONAL
SYMBOL OF
ACCESSIBILITY
(ISA)

The International Symbol of Accessibility shall comply with Figure 11B-703.7.2.1. The white figure on a blue background. The blue shall be FS 15090 in Federal Standard 595C.

Distance between dots in the same cell

Distance between dots in adjacent cells

Distance between dots in the same cell

Distance between corresponding dots from one cell directly below

Distance between dots in adjacent cells

Distance between dots in the same cell

Distance between dots in adjacent cells

Distance between dots in the same cell

